


Third Floor
Sykeston School

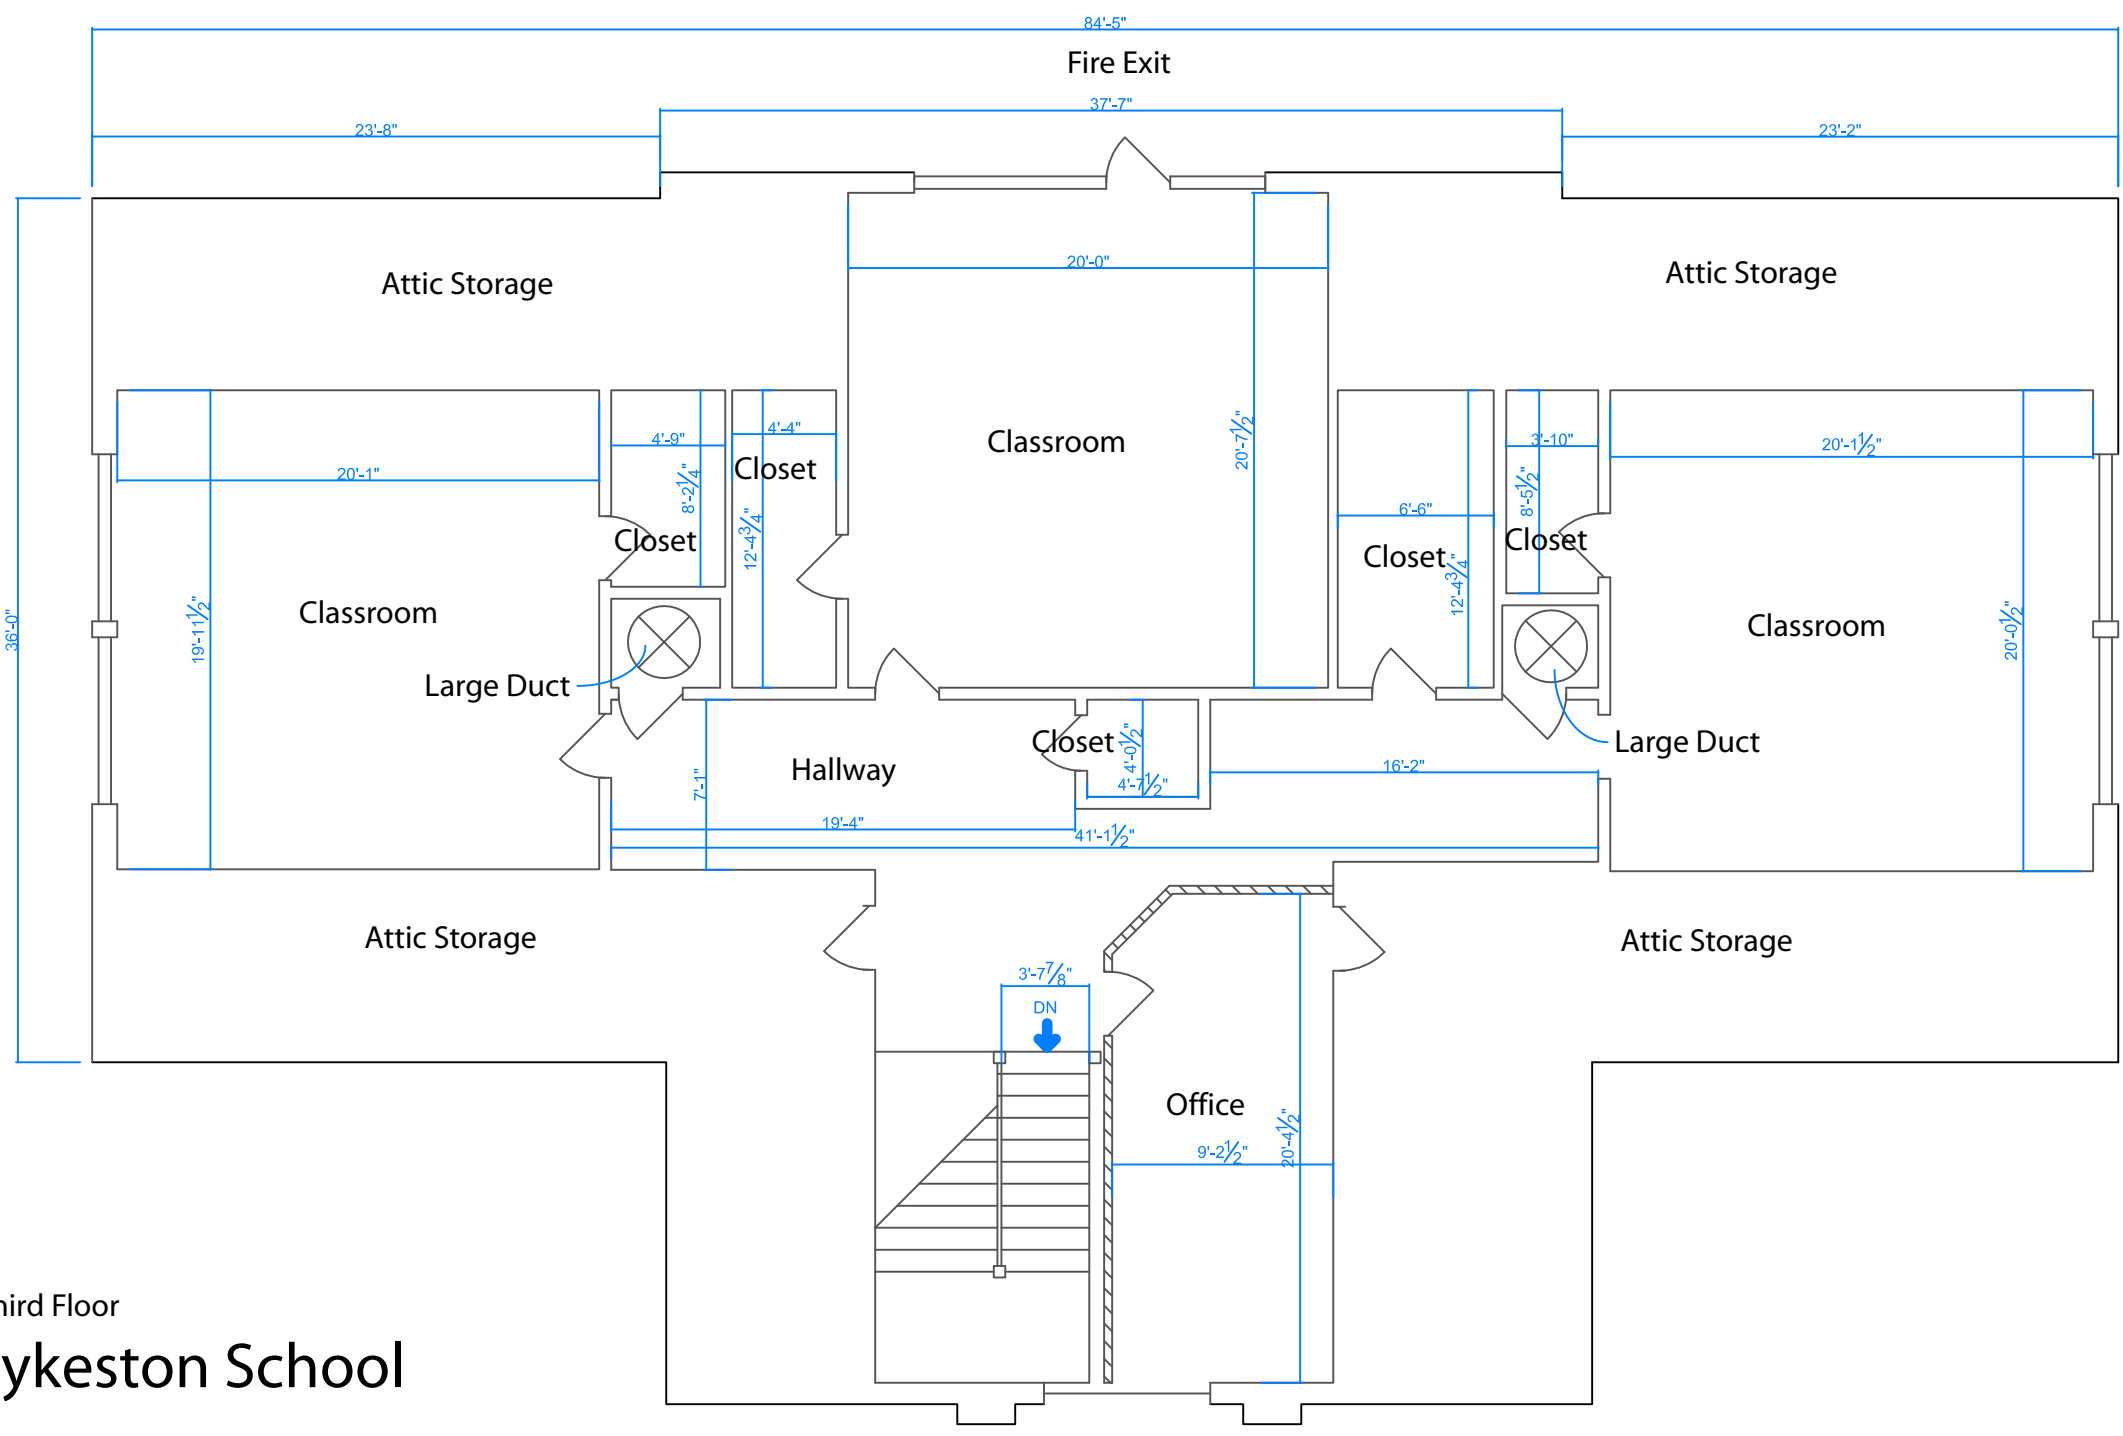

Temporary Partition

