


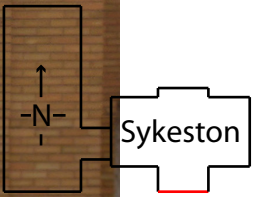

HIGH SCHOOL

1913



4'2" 3'4" 1'1" 3'3" 3" 3" 3'3" 1'1" 3'3" 4'3"
12'1" 2'5" 8'6" 2'5" 12'1"
37'6"